FD #	CONV #	CONV TYPE	MOTOR HP	LENGTH	COMMENTS

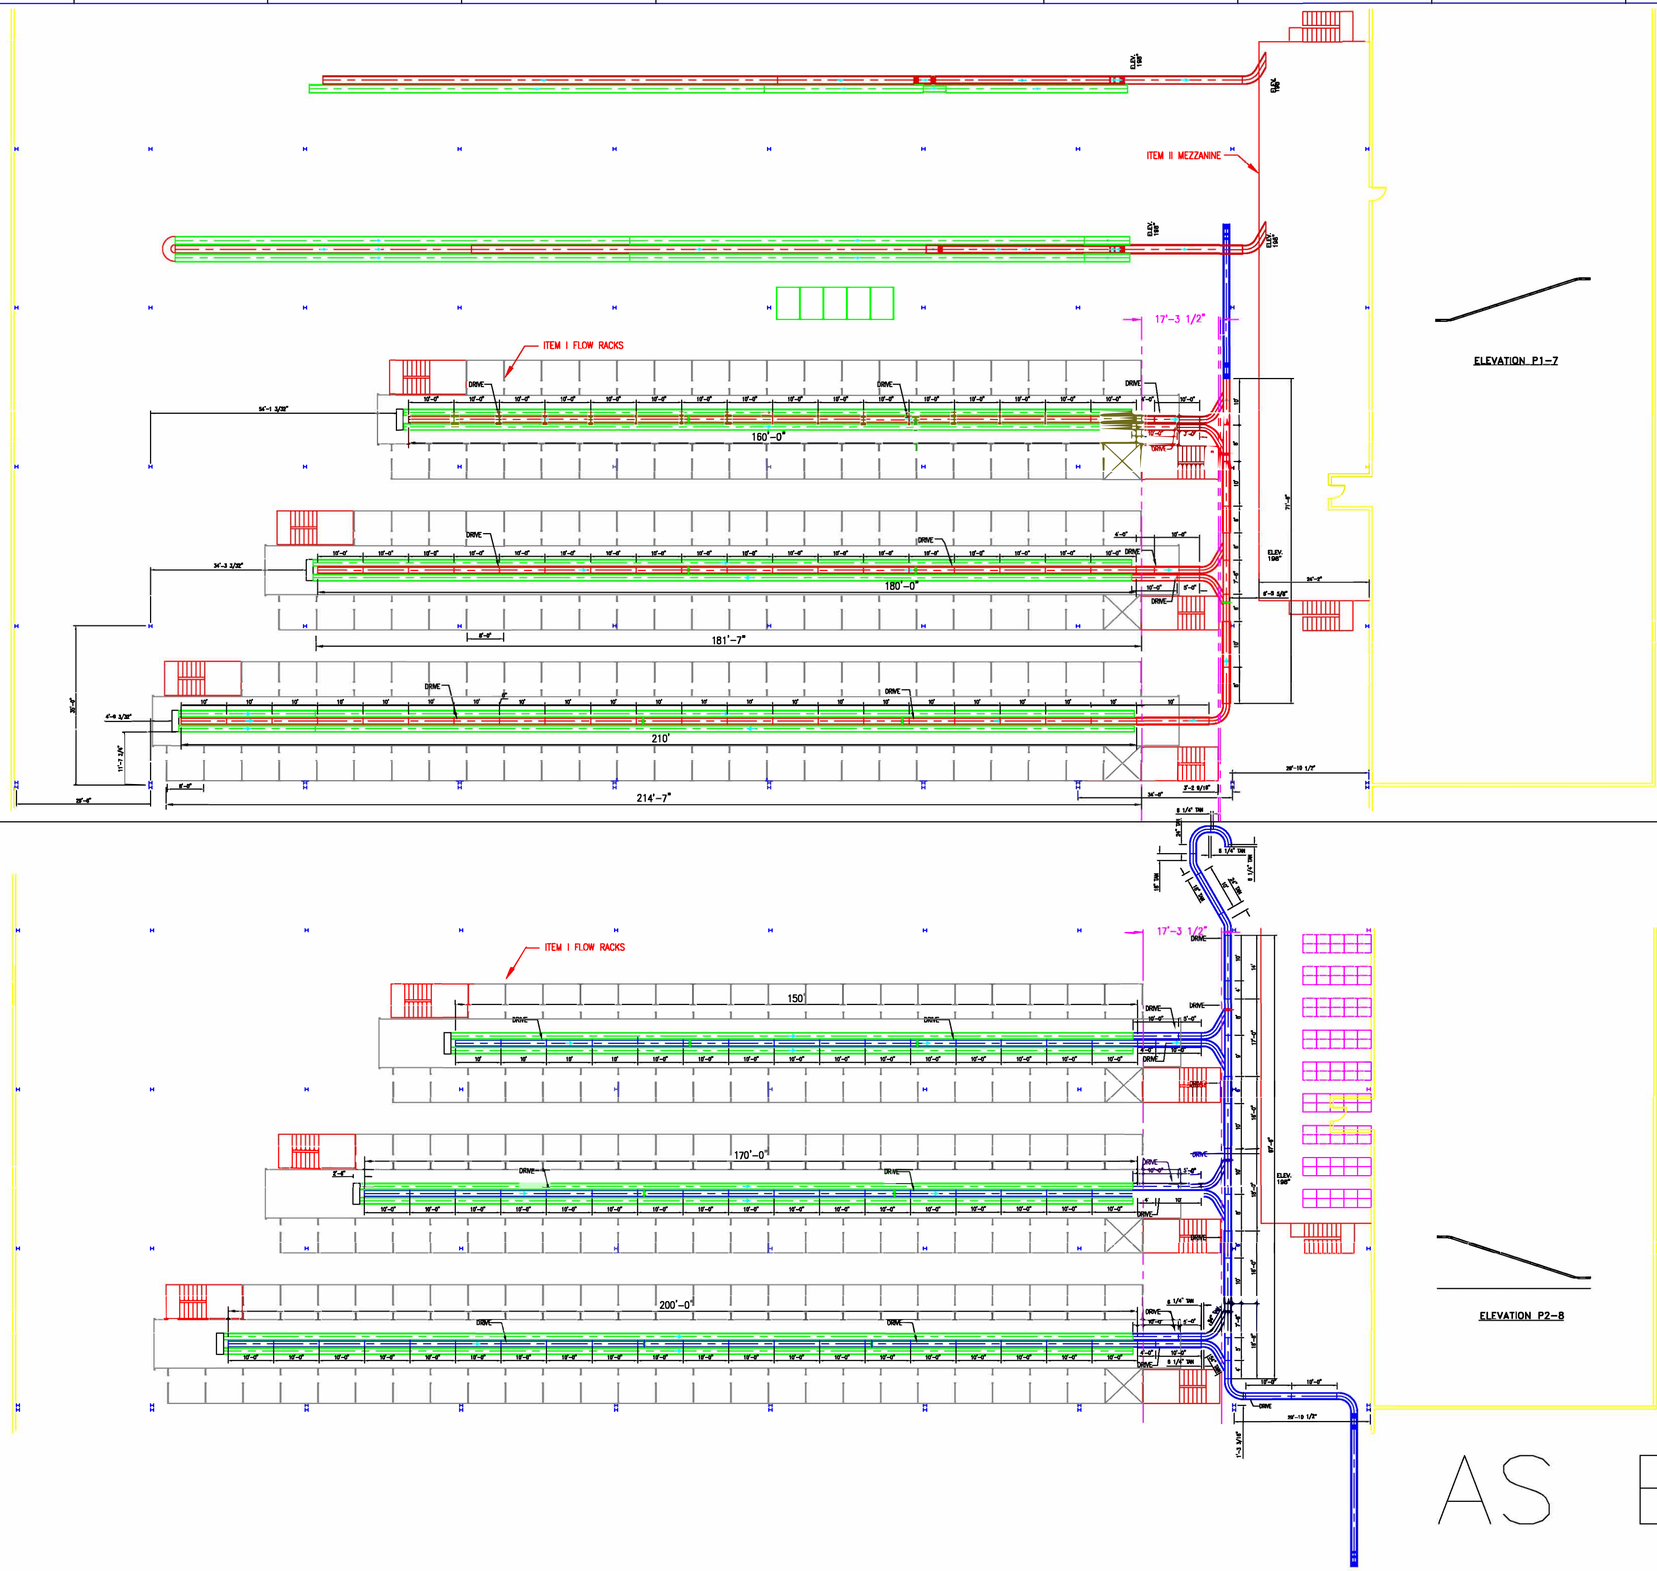

AS BUILT

REV.	DATE	DESCRIPTION	BY
A			

WEPCO MATERIAL HANDLING SPECIALISTS
O'HARA INDUSTRIAL PARK
PITTSTON, PA 18640
PHONE (570) 655-5951
FAX (570) 655-0934

TITLE

FLOW RACK ORDER PICKING SYSTEM

DRAWN BY	DATE	DRAWING #
SLA	5-12-99	1097-5
SCALE 1/16"=1'	CHECKED BY	