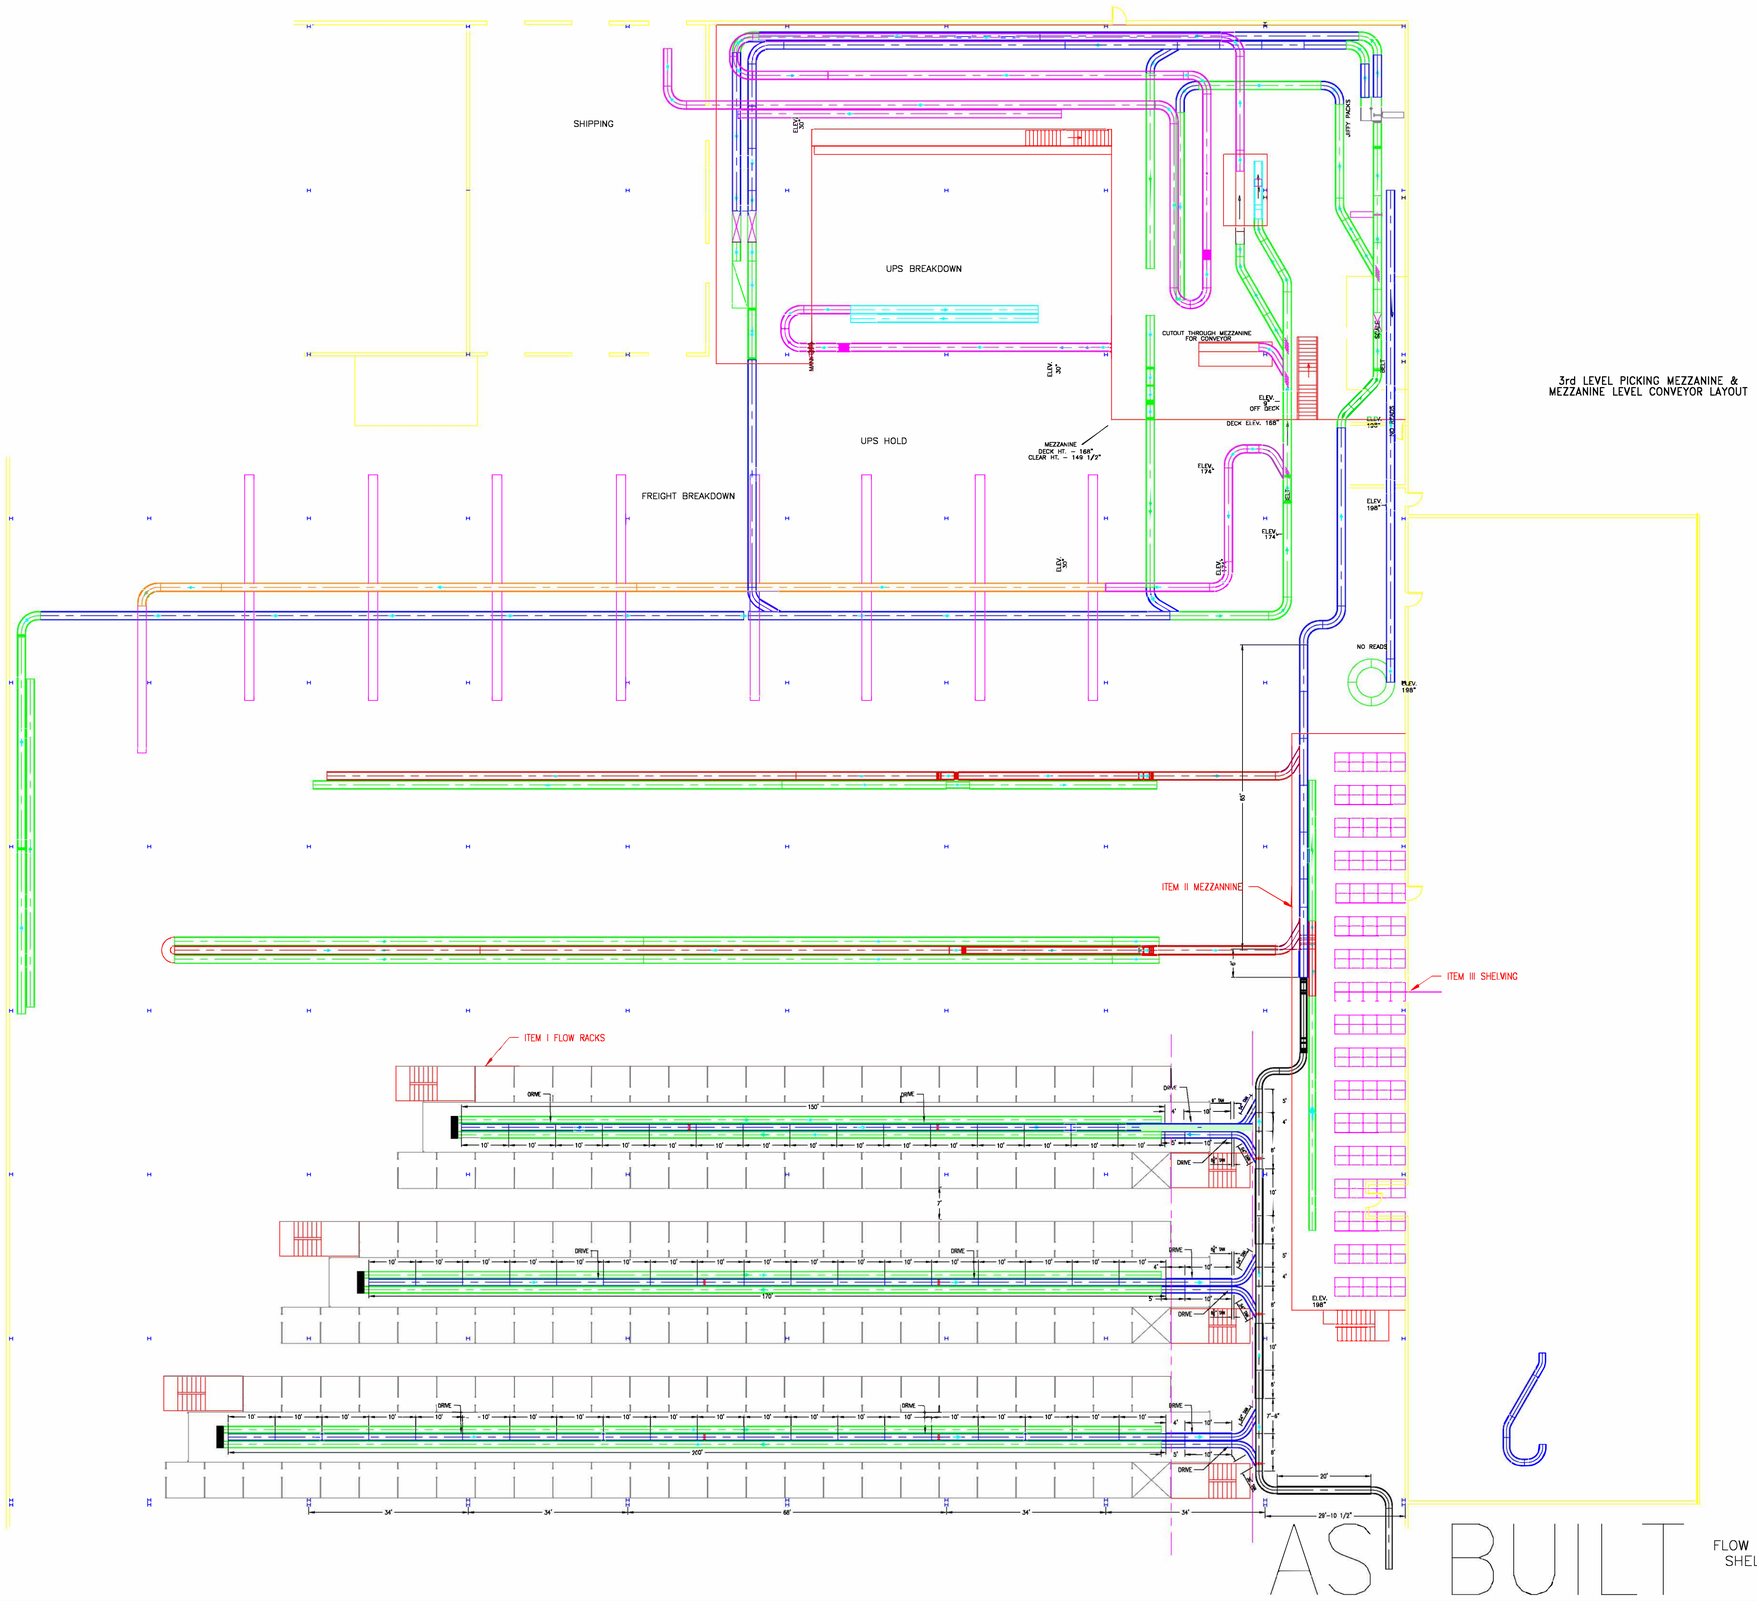

3rd LEVEL PICKING MEZZANINE &
MEZZANINE LEVEL CONVEYOR LAYOUT

FO #	CONV #	CONV TYPE	MOTOR HP	LENGTH	COMMENTS

AS BUILT

FLOW RACK POSITIONS – 12,330
SHELVING POSITIONS – 2,550
TOTAL – 14,880

REV.	DATE	DESCRIPTION	BY
A			

WEPCO
MATERIAL HANDLING SPECIALISTS

O'HARA INDUSTRIAL PARK
PITTSTON, PA 18640
PHONE (570) 655-5951
FAX (570) 655-0934

TITLE
FLOW RACK ORDER PICKING SYSTEM

DRAWN BY	DATE	DRAWING #
SLA	5-12-99	1097-6
SCALE 1/16"=1'	CHECKED BY	